BRUHAT BANGALORE MAHANAGARA PALIKE

Improvements to widen portion of roads,construction of New drains,UG cable duct and Footpath at Doddabommasandra main road surrounding road in Ward No.10

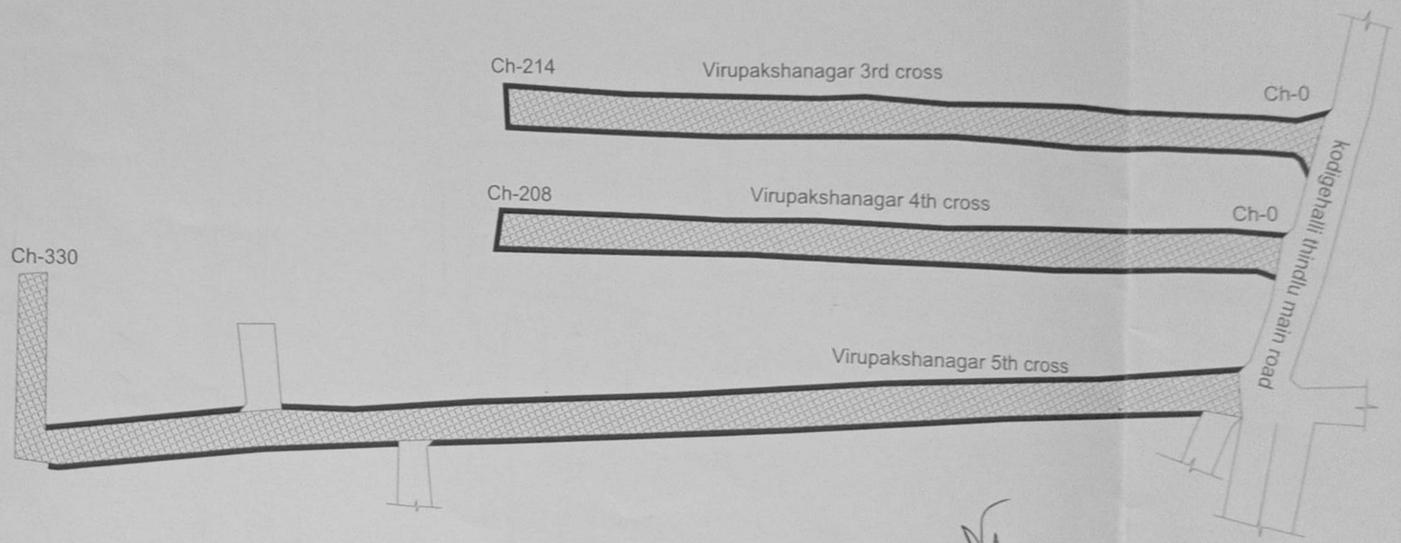

AE

Asst. Executive Engineer
Project Division
Yelahanka Zone
BBMP, Bangalore - 92

NOTE:-
1. ALL DIMENSION & LEVELS ARE Mts. UNLESS OTHERWISE MENTIONED.

DATE | No. OF PRINTS | PRINTS ISSUED TO | SIGN

DATE | REVISION | DESCRIPTIONS | SIGN

New Asphalt Road

Existing Drain

CONSULTANT:
TEJUS CONSULTANTS
No.38 MSC, 4th Cross, 3rd Main
1st Stage, Basaveshwaranagar
Bangalore-560079
TEL.: 080 - 23287532
email: tejusconsultants@gmail.com

TITLE:
As Built Drawing

Scanned by TapScanner

BRUHAT BANGALORE MAHANAGARA PALIKE

Improvements to widen portion of roads,construction of New drains,UG cable duct and Footpath at Doddabommasandra main road surrounding road in Ward No.10

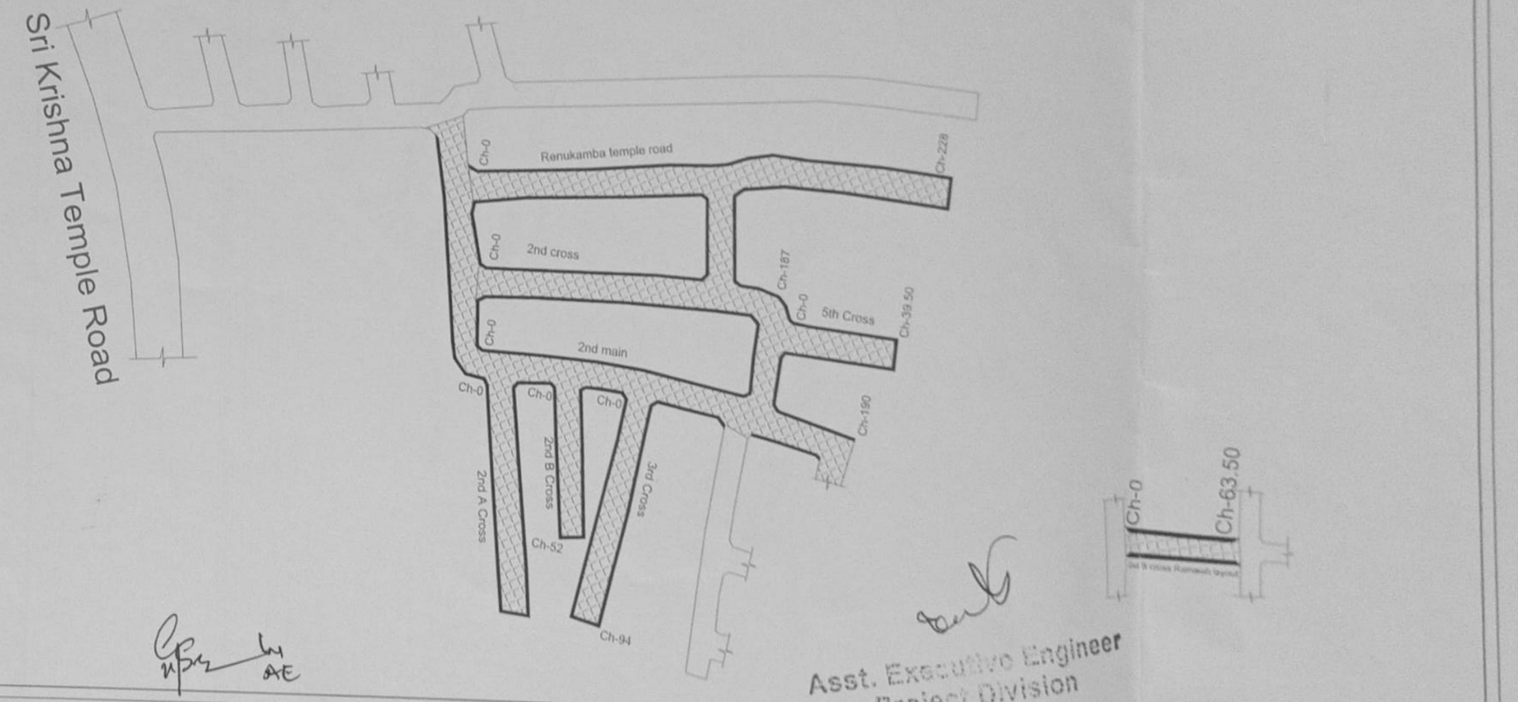

Asst. Executive Engineer
Project Division
Yelahanka Zone
BBMP, Bangalore - 92

1. ALL DIMENSION & LEVELS ARE Mts. UNLESS OTHERWISE MENTIONED.

DATE No. OF PRINTS PRINTS ISSUED TO SIGN

DATE REVISION DESCRIPTIONS SIGN

Asphalt Overlay

Existing Drain

CONSULTANT:
TEJUS CONSULTANTS

TITLE:
As Built Drawing

Scanned by TapScanner

BRUHAT BANGALORE MAHANAGARA PALIKE

Improvements to widen portion of roads,construction of New drains,UG cable duct and Footpath at Doddabommasandra main road surrounding road in Ward No.10

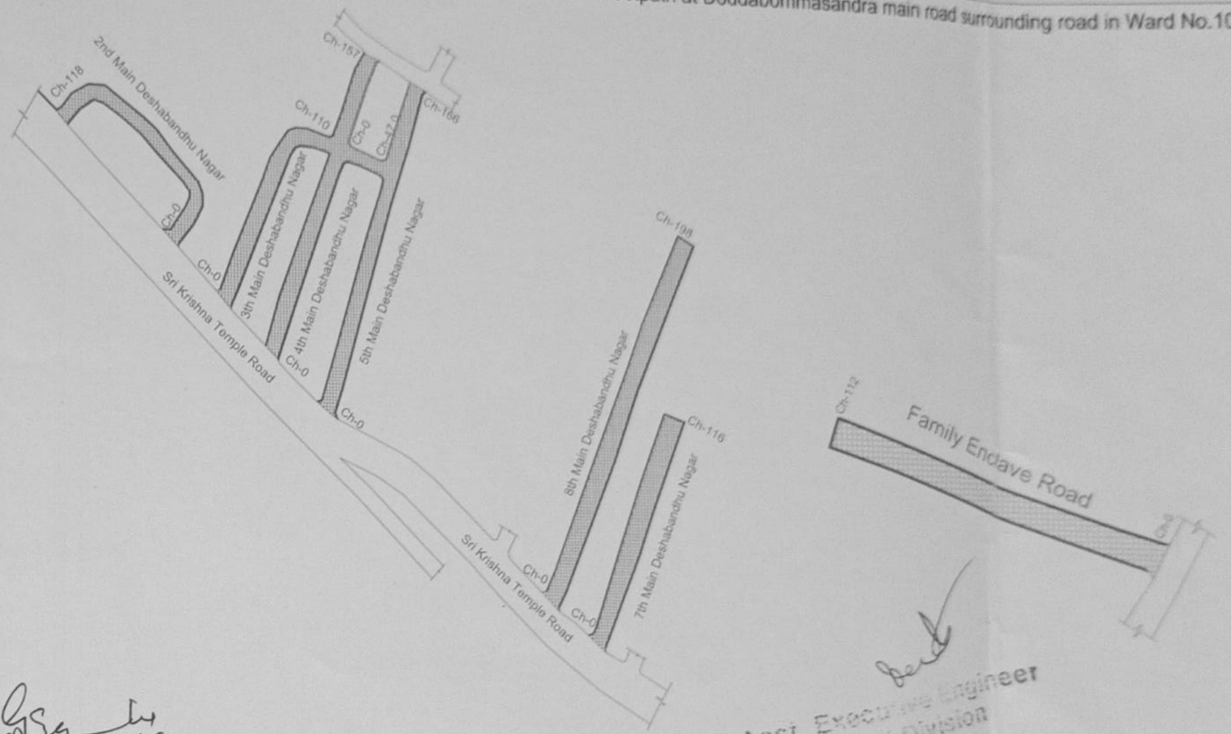

AE

Asst. Executive Engineer
Project Division
Yelahanka Zone
BBMP, Bangalore - 92

NOTE:-

1. ALL DIMENSION & LEVELS ARE Mts. UNLESS OTHERWISE MENTIONED.

DATE	No. OF PRINTS	PRINTS ISSUED TO	SIGN

DATE	REVISION	DESCRIPTIONS	SIGN

Asphalt Overlay

Existing Drain

CONSULTANT

TEJUS CONSULTANTS

TITLE:

As Built Drawing

Yelahanka

Scanned by TapScanner